

NOTES:

ALL DIMENSIONS SHALL BE CHECKED AND CO-RELATED WITH THE STRUCTURAL DRAWING AND ANY AMBIGUITY SHALL BE IMMEDIATELY BROUGHT TO THE NOTICE OF THE ARCHITECTS BEFORE COMMENCEMENT OF THE WORK.

TECHNICAL NOTES:

1. ALL DIMENSIONS ARE IN MILLIMETER

2. ALL LEVELS ARE IN METER

GENERAL NOTES:

F.F.L - FINISHED FLOOR LEVEL.

F.G.L - FORMED GROUND LEVEL.

-> - INDICATES 15 MM DROP IN TOILET FLOOR.

T.O.C - TOP OF CONCRETE

R.W.P - RAIN WATER PIPE

JOINERY SCHEDULE			
TYPE	OPENING SIZE	CASMENT SIZE	DESCRIPTION
	WIDTH	HEIGHT	
MD	2400	2400	2375 2385 GLAZED STEEL DOOR
D	2000	2400	1975 2385 STEEL DOOR WITH VISION PANEL
D1	1200	2400	1175 2385 STEEL DOOR WITH VISION PANEL
D2	1000	2400	975 2385 STEEL DOOR WITH FIXED GLASS/SIGNAGE (TOILET)
D3	750	2100	725 2075 PVC DOOR (TOILET)
DA	900	2100	875 2075 PVC DOOR (PH.TOILET)

WINDOW			
W1	W2	W3	W4
5000x2600	1500x2600	1475x2575	1500x1400
4975x2575	1475x2575	1500x1400	1500x1200
5000x2600	1500x1400	1500x1200	1500x1200
5000x2600	1500x1400	1500x1200	1500x1200
5000x2600	1500x1400	1500x1200	1500x1200

VENTILATOR			
W1	W2	W3	W4
2000x600	1975x575	2000x600	1975x575
5994x750	-	2000x600	1975x575
3000x3600	2400x3600	2400x3600	2400x3600
2400x2100	2375x2075	1500x1400	1475x1375
1500x2400	-	1500x2400	-

NOTE:

PROVIDED RC MULLION 200X200 WITH 4NOS Y12 AND Y8 @ 150GC FOR ALL WALLS OF LENGTH 6M AND ABOVE TO TAKE CARE OF SLENDerness RATIO

NOTE:

1. REFER SEPARATE DRAWING FOR TOILET/PLUMBING DETAIL.

2. REFER SEPARATE JOINERY DRAWING FOR JOINERY DETAILS.

3. REFER SEPARATE DRAWING FOR FLOORING DETAIL.

4. ALL PLENUM WALLS ARE 115MM THK BRICK WALL.


DRAWING TITLE:
AS BUILT DRAWING-


**FLOOR - 1
LABORATORY BLOCK-2
(WORKSHOP)**

PROJECT:
IIT TIRUPATI
TRANSIT CAMPUS

NO.	DATE	REVISIONS	SCALE	REV	DRAWN	CHKD
0	26.04.19	AS BUILT DRAWING	M.M			
1		REMARKS				

ARCHITECTS:
THRESHOLD ARCHITECTS
NO:5 8th LANE INDIRA NAGAR,
ADYAR - CHENNAI - 20
PHONE : 42115680 / 42115681
email: enquiry@thresholdarchitects.com

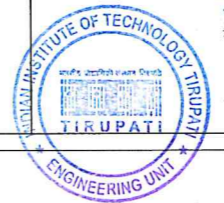

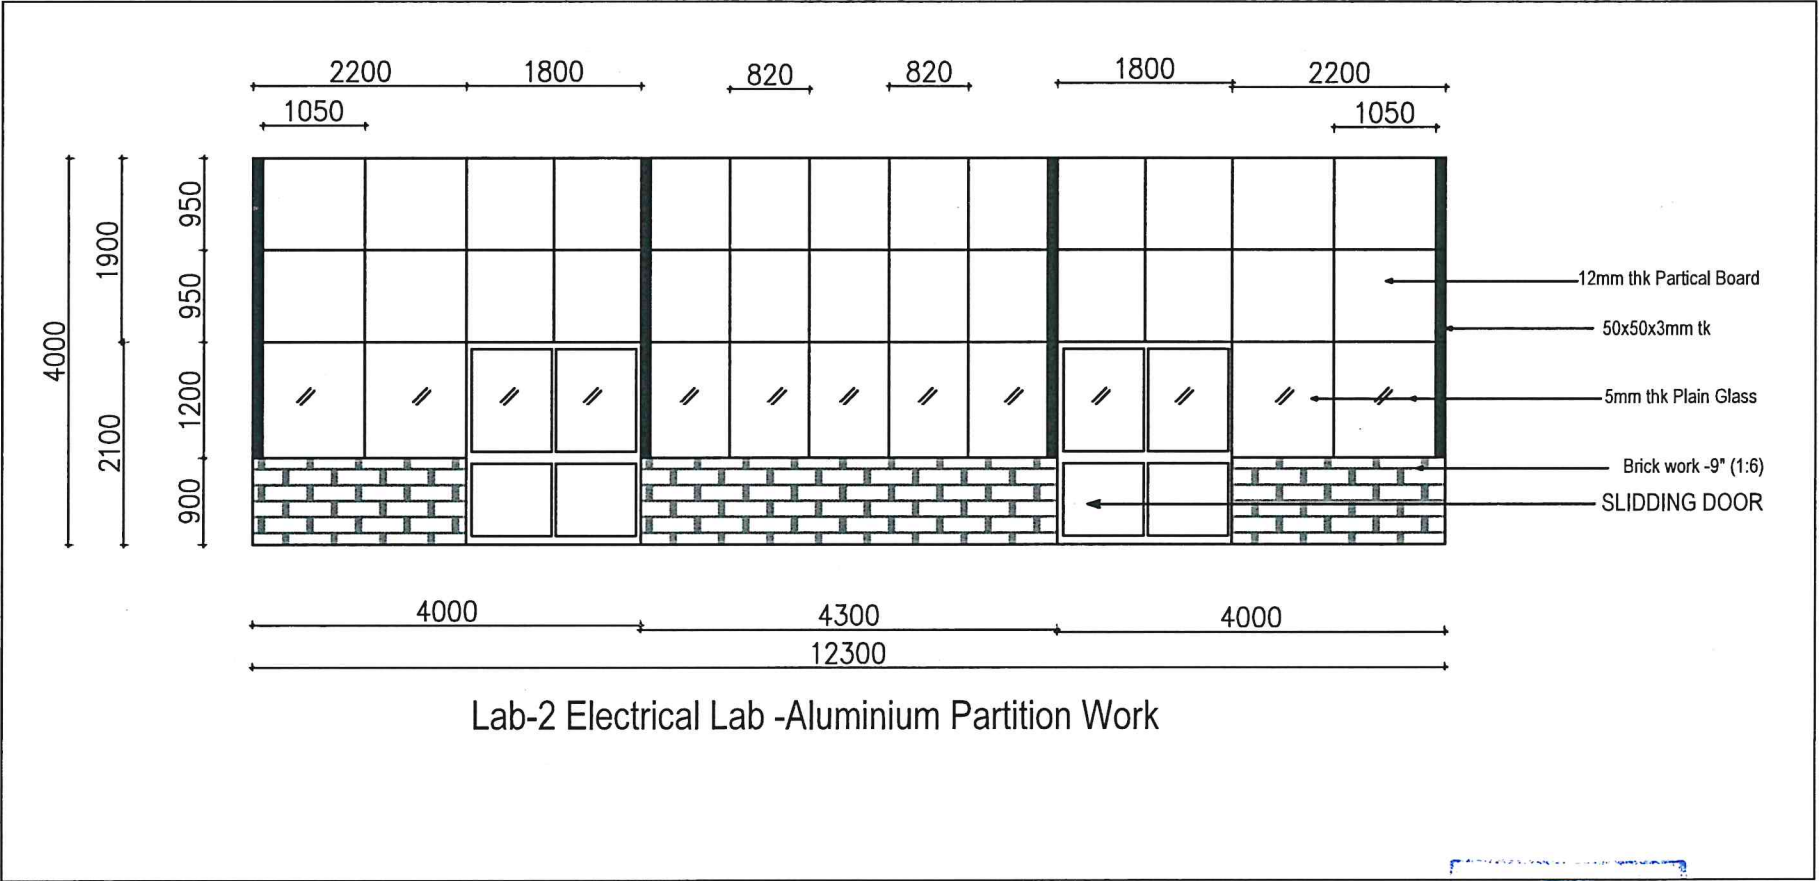

Lab-2 Electrical Lab -Aluminium Partition Work

